



PRODUCED BY
CITY OF FORT WAYNE
G.I.S. DEPARTMENT


LEGEND

- FIRE HYDRANT
- MAIN LINE VALVE
- BUTTERFLY VALVE
- BLOWOFF VALVE
- CHECK VALVE
- VALVE PIT
- WATER JUNCTION
- REDUCER
- CUT PLUG
- WATER TANK
- WATER MAIN
- PRIVATE MAIN
- ABANDONED MAIN
- EASEMENTS
- R22 1765 HYDRANT ID
- R22 0026 VALVE ID
- R22 0026 JUNCTION ID
- R22 0026 REDUCER ID


NOTICE: THE INFORMATION DEPICTED ON THIS MAP CONCERNING LOCATION, TYPE, SIZE AND MATERIAL OF UNDERGROUND UTILITIES IS NOT GUARANTEED TO BE ACCURATE OR ALL INCLUSIVE. INFORMATION SHOWN WAS OBTAINED FROM AVAILABLE RECORDS. FIELD INVESTIGATION SHOULD BE CONDUCTED TO DETERMINE ACCURACY.

CITY OF FORT WAYNE
CITY UTILITIES
 CITIZENS SQUARE
 200 E. BERRY STREET
 FORT WAYNE, IN 46802

SE 1/4 SEC. 17
 TOWNSHIP 31 N, RANGE 13 E
 ST JOSEPH TWP, ALLEN CO.
 MAP SCALE : 1" = 200'

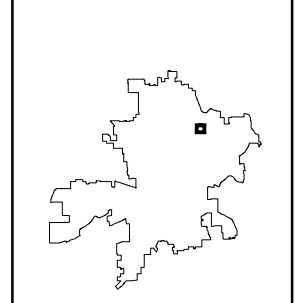

MAP NO.
S38
 4/1/2024

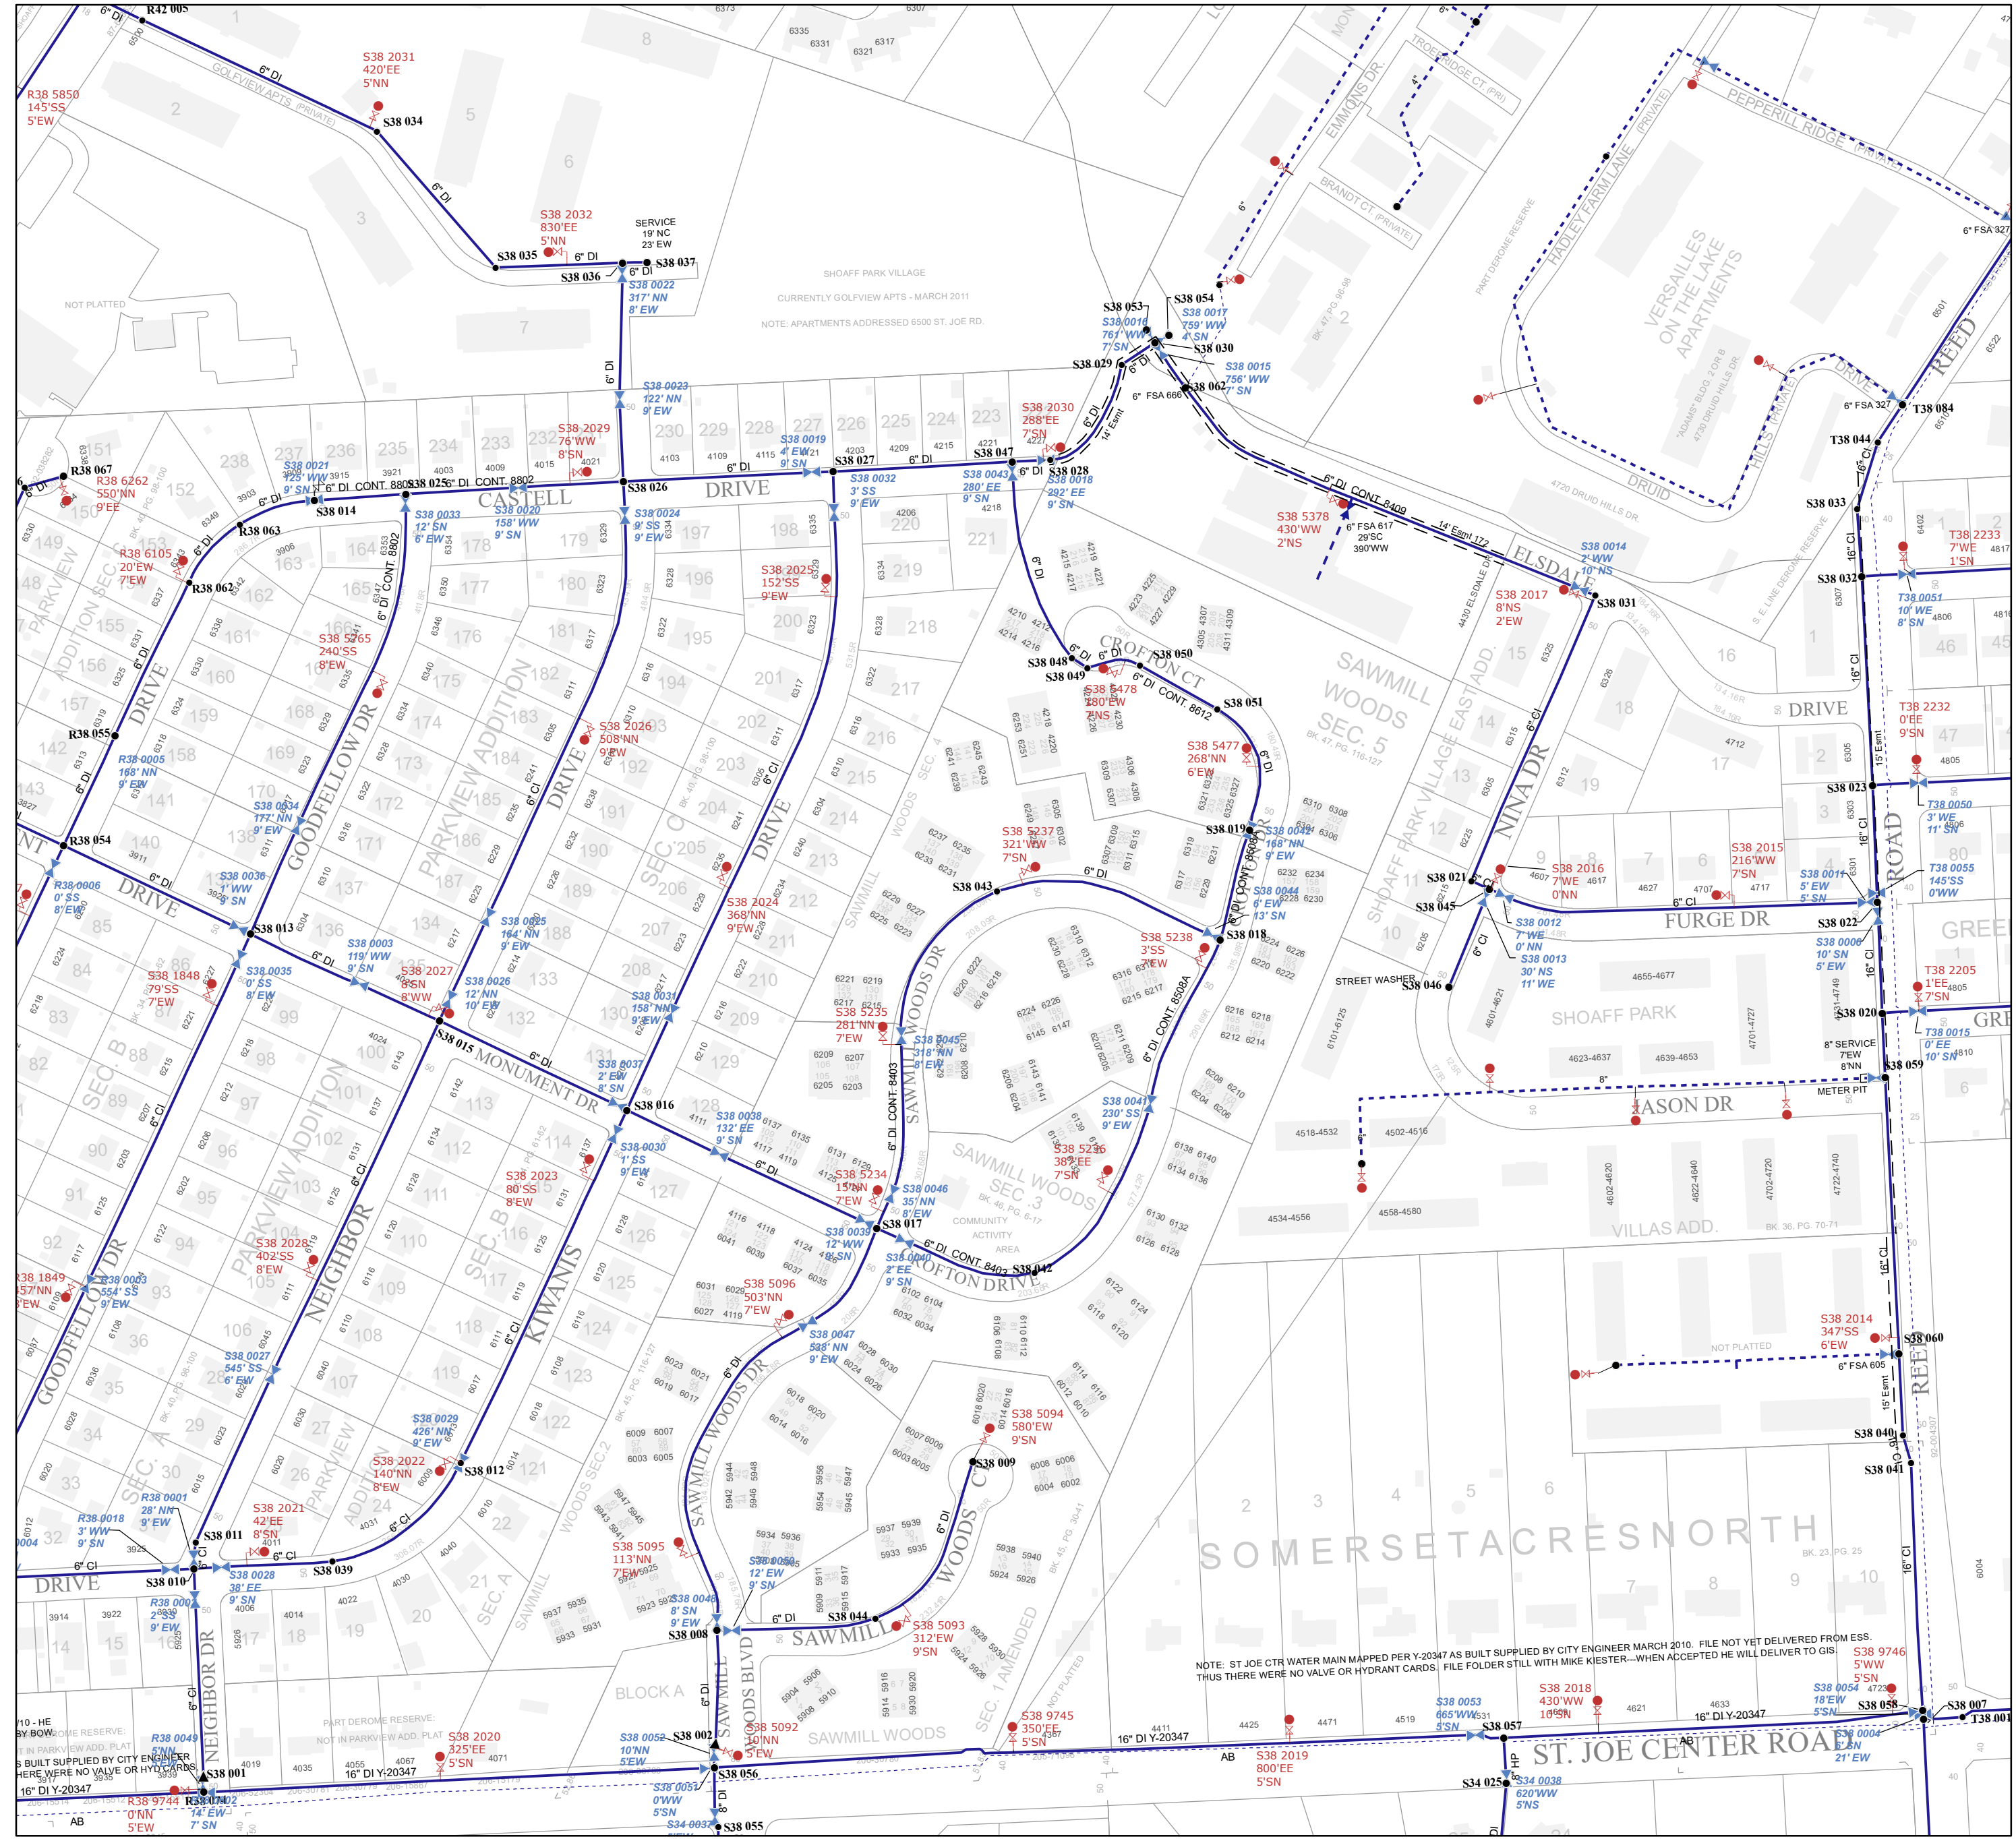

NOTE: ST JOE CTR WATER MAIN MAPPED PER Y-20347 AS BUILT SUPPLIED BY CITY ENGINEER MARCH 2010. FILE NOT YET DELIVERED FROM ESS. S38 9746
 THUS THERE WERE NO VALVE OR HYDRANT CARDS. FILE FOLDER STILL WITH MIKE KIESTER--WHEN ACCEPTED HE WILL DELIVER TO GIS S38 005
 S38 2018 430'WW 10'NS
 S38 0053 465'WW 4'SN
 S38 2019 800'EE 5'SN
 S38 0054 620'WW 5'NS
 S38 0055 18'EW 5'SN
 S38 0056 472'EE 21'EW
 S38 0057 16'DI Y-20347
 S38 0058 472'EE 21'EW
 S38 0059 472'EE 21'EW
 S38 0060 472'EE 21'EW